
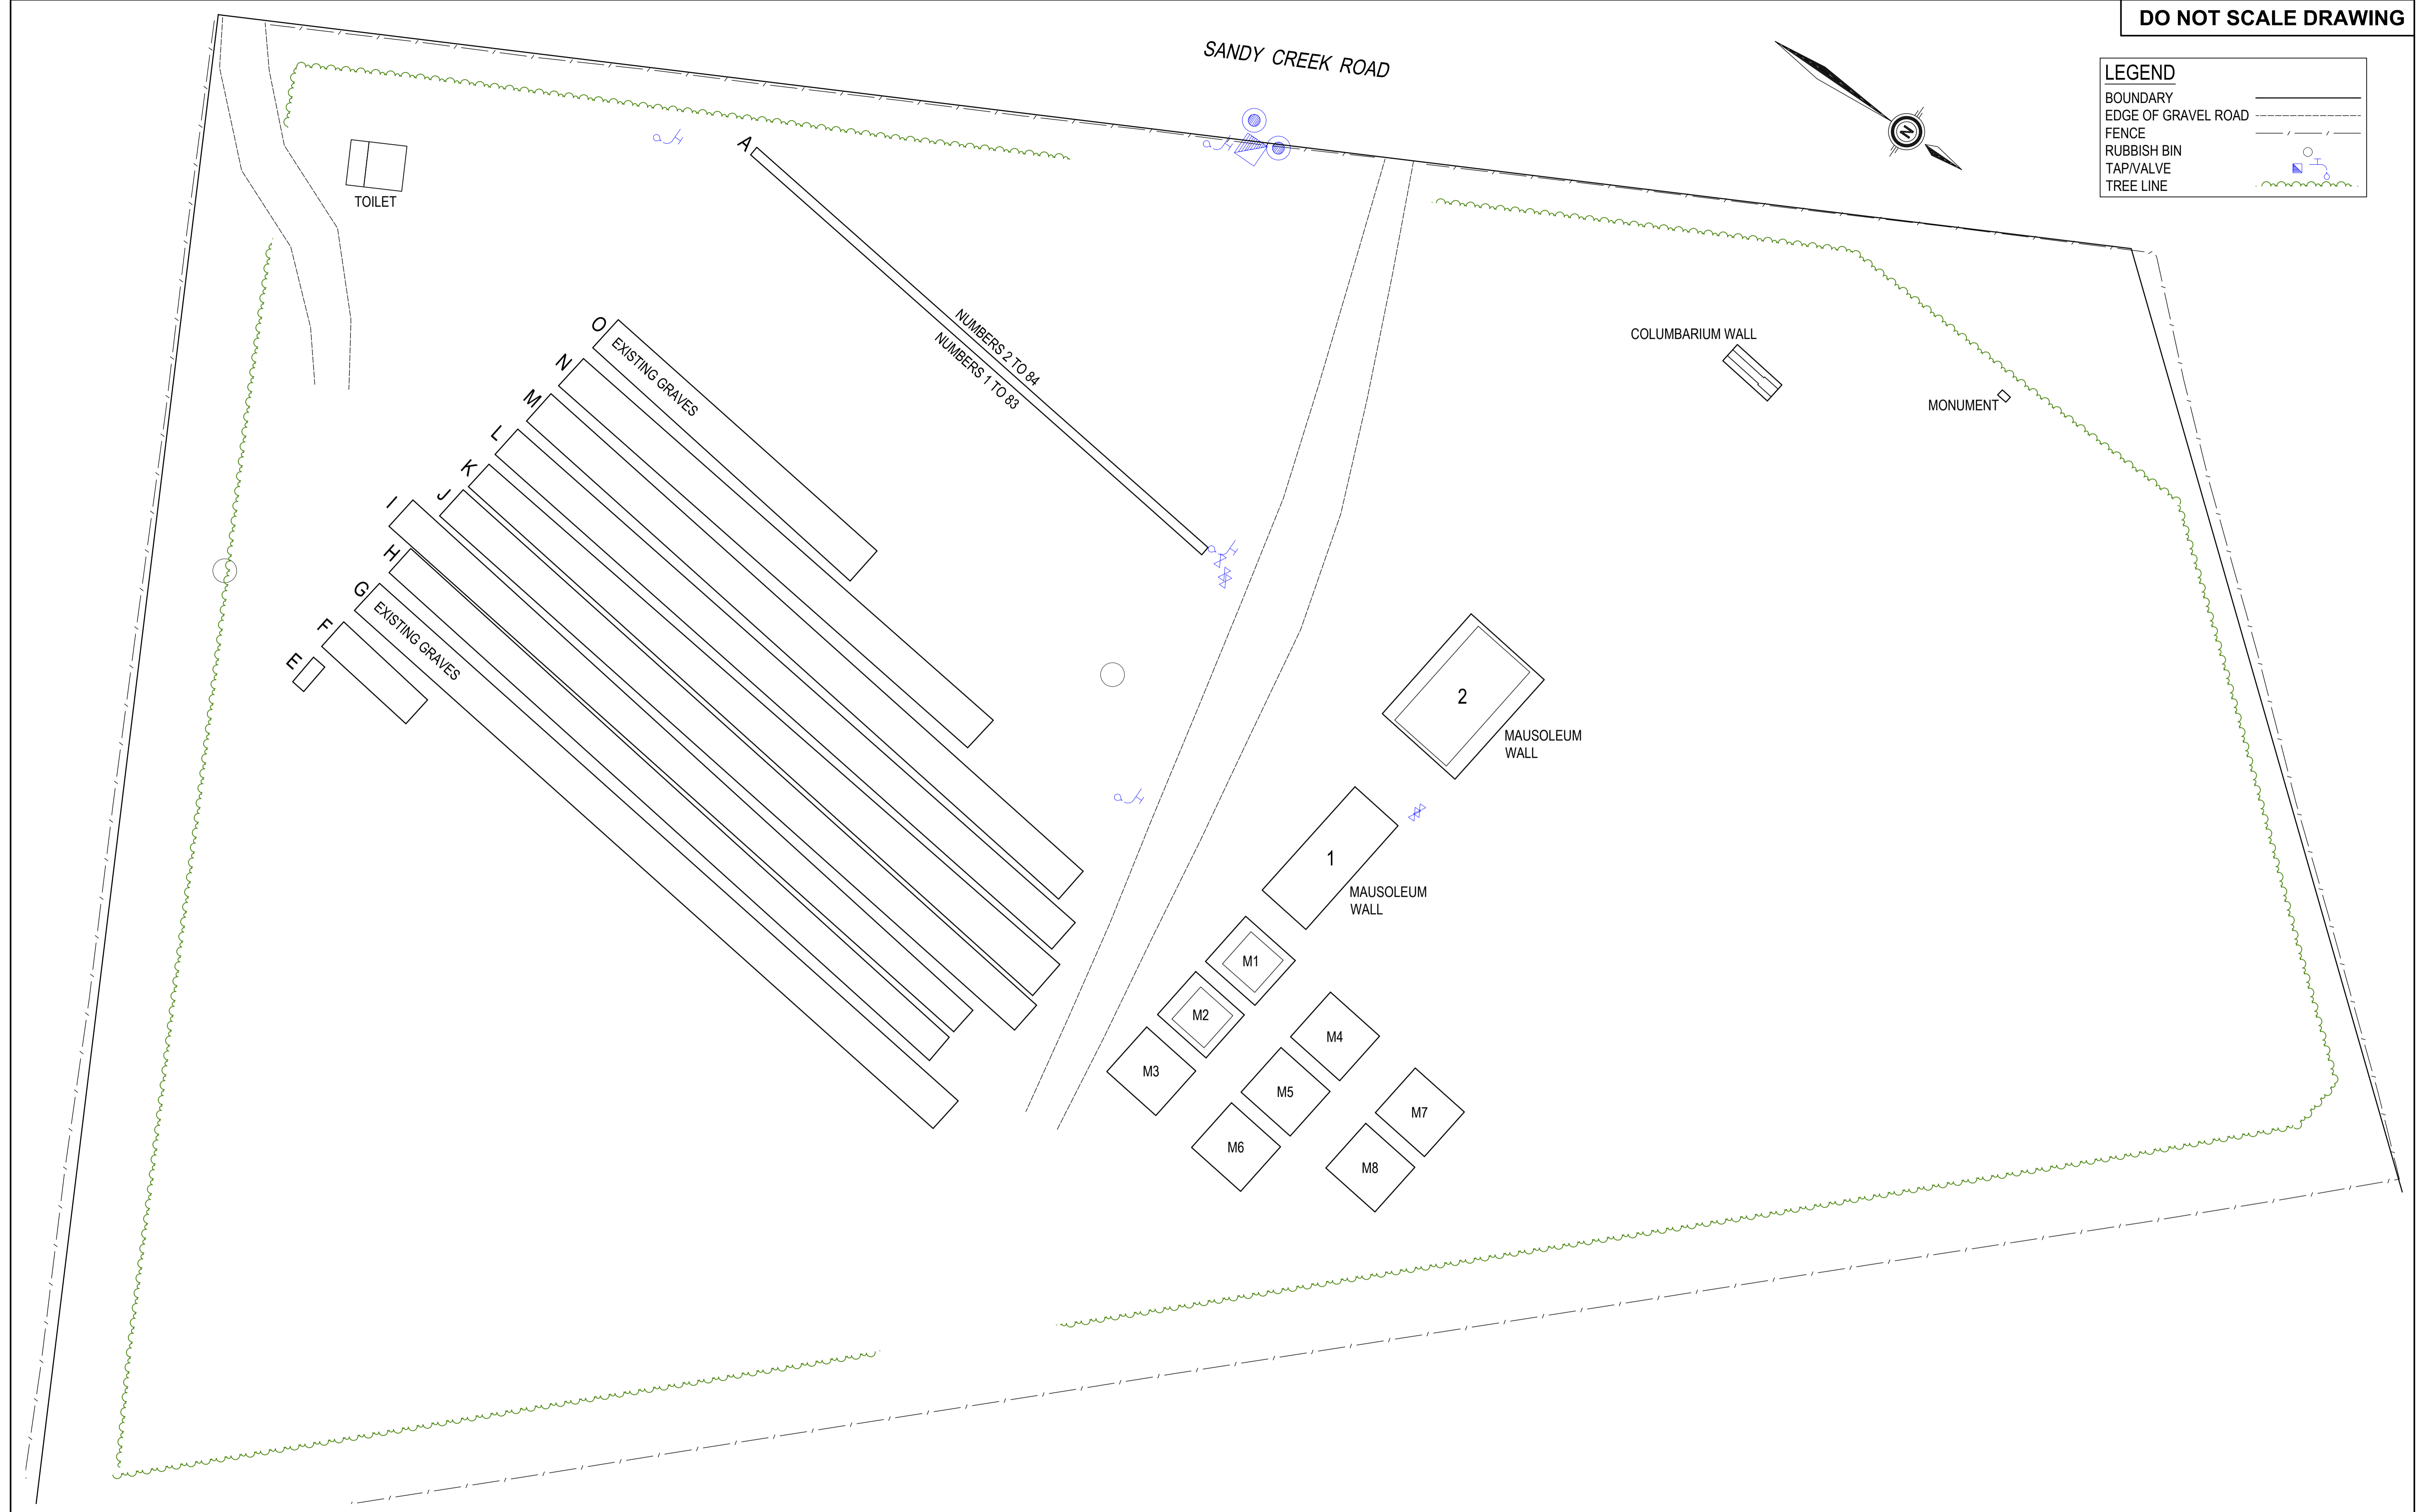


DO NOT SCALE DRAWING

LEGEND

- BOUNDARY
- EDGE OF GRAVEL ROAD
- FENCE
- RUBBISH BIN
- TAP/VALVE
- TREE LINE

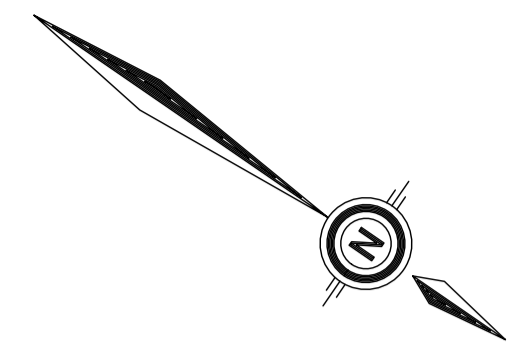

No	Revision	Note: * Indicates signatures on original issue of drawing or last revision of drawing	Drawn	Project Director	Date
B	LAYOUT UPDATED, COLUMBARIUM WALL AND TOILET BLOCK ADDED		JH		18/6/19
A	INITIAL ISSUE		VAM		2/7/17

0 2.5 5 7.5 10 12.5m

SCALE 1:500 (A3) 1:250 (A1)

Mareeba SHIRE COUNCIL

11-15 Kowa Street, Mareeba, QLD 4880 Australia
 PO Box 154, Mareeba QLD 4880
 T 1300 308 461 F 07 4092 3323
 E info@msc.qld.gov.au

DO NOT SCALE	Drawn V.MADRID	Designer V.MADRID
Conditions of Use: The concepts and information contained in this document is the copyright of the Mareeba Shire Council (MSC). Use or copying of this document in whole or in part without the written permission of the MSC constitutes an infringement of copyright.	Drafting Check	Design Check
	Approved (Project Director)	Date
Scale 1:250	This Drawing must not be used for Construction unless signed as Approved	

MAREEBA SHIRE COUNCIL		Original Size
Project DIMBULAH CEMETERY		A1
Title DIMBULAH CEMETERY AS CONSTRUCTED		Series No
		1 of 1
Construction Job No: 02334	Drawing No: DIM_CEM	Rev: B